

	<h1>Medical University of South Carolina</h1> <p>Amendment 3</p>	Solicitation Number Date Printed Date Issued Procurement Officer Phone E-Mail Address	Q191100ADD January 3, 2019 January 3, 2019 Angie DeVeaux 843-792-2389 deveauan@musc.edu
---	---	--	--

DESCRIPTION: **Fabricate and Install Steel Beam-W8x18**
 USING GOVERNMENTAL UNIT: Medical University of South Carolina

The Term "Offer" Means Your "Bid" or "Proposal".

SUBMIT OFFER BY (Opening Date/Time): **January 22, 2019 @ 10:00PM(EST)** (Local) See "Deadline for Submission of Offer" provision

QUOTATIONS MAY BE FAXED TO: 843-792-3884

QUESTIONS MUST BE RECEIVED BY: **January 16, 2019 @ 10:00AM(EST)** See "Questions From Offeror" provision

NUMBER OF COPIES TO BE SUBMITTED: **One COPY**

SUBMIT YOUR OFFER TO THE FOLLOWING ADDRESS:

PHYSICAL ADDRESS:
 Medical University of South Carolina
 University Purchasing
 19 Hagood Avenue, Suite 408
 Charleston, SC 29425

See "Submitting Your Offer" provision

CONFERENCE TYPE: Site Visit(Not Mandatory) DATE & TIME: January 15, 2019 at 10:00am(EST) Please bring your certificate of insurance. As appropriate, see "Conferences - Pre-Bid/Proposal" & "Site Visit" provisions		LOCATION: MUSC Engineering & Facilities 2nd floor Room PG203B Small conference room 97 Johnathan Lucas Street Charleston, SC 29425	
AWARD & AMENDMENTS	Award will be posted at the Physical Address stated above on 01/22/19 . The award, this solicitation, and any amendments will be posted at the following web address: https://web.musc.edu/about/leadership/institutional-offices/finance/vendor-portal/solicitations		
You must submit a signed copy of this form with Your Offer. By submitting a bid or proposal, You agree to be bound by the terms of the Solicitation. You agree to hold Your Offer open for a minimum of thirty (30) calendar days after the Opening Date.			
NAME OF OFFEROR <small>(Full legal name of business submitting the offer)</small>		OFFEROR'S TYPE OF ENTITY: <small>(Check one)</small>	
AUTHORIZED SIGNATURE <small>(Person signing must be authorized to submit binding offer to enter contract on behalf of Offeror named above.)</small>		<input type="checkbox"/> Sole Proprietorship <input type="checkbox"/> Partnership <input type="checkbox"/> Corporation (tax-exempt) <input type="checkbox"/> Corporate entity (nontax-exempt)	
TITLE <small>(Business title of person signing above)</small>		<input type="checkbox"/> Government entity (federal, state, or local) <input type="checkbox"/> Other _____	
PRINTED NAME <small>(Printed name of person signing above)</small>	DATE SIGNED		
Instructions regarding Offeror's name: Any award issued will be issued to, and the contract will be formed with, the entity identified as the offeror above. An offer may be submitted by only one legal entity. The entity named as the offeror must be a single and distinct legal entity. Do not use the name of a branch office or a division of a larger entity if the branch or division is not a separate legal entity, <i>i.e.</i> , a separate corporation, partnership, sole proprietorship, etc.			
STATE OF INCORPORATION		<small>(If offeror is a corporation, identify the state of Incorporation.)</small>	
TAXPAYER IDENTIFICATION NO. <small>(See "Taxpayer Identification Number" provision)</small>			

PAGE TWO

(Return Page Two with Your Offer)

HOME OFFICE ADDRESS (Address for offeror's home office / principal place of business)	NOTICE ADDRESS (Address to which all procurement and contract related notices should be sent.) (See "Notice" clause)
	_____ Area Code - Number - Extension Facsimile
	_____ E-mail Address

PAYMENT ADDRESS (Address to which payments will be sent.) (See "Payment" clause)	ORDER ADDRESS (Address to which purchase orders will be sent) (See "Purchase Orders and "Contract Documents" clauses)
_____ Payment Address same as Home Office Address _____ Payment Address same as Notice Address (check only one)	_____ Order Address same as Home Office Address _____ Order Address same as Notice Address (check only one)

ACKNOWLEDGMENT OF AMENDMENTS
 Offerors acknowledges receipt of amendments by indicating amendment number and its date of issue. (See "Amendments to Solicitation" Provision)

Amendment No.	Amendment Issue Date						

DISCOUNT FOR PROMPT PAYMENT (See "Discount for Prompt Payment" clause)	10 Calendar Days (%)	20 Calendar Days (%)	30 Calendar Days (%)	_____ Calendar Days (%)
--	----------------------	----------------------	----------------------	-------------------------

PREFERENCES - A NOTICE TO VENDORS (SEP. 2009): On June 16, 2009, the South Carolina General Assembly rewrote the law governing preferences available to in-state vendors, vendors using in-state subcontractors, and vendors selling in-state or US end products. This law appears in Section 11-35-1524 of the South Carolina Code of Laws. A summary of the new preferences is available at www.procurement.sc.gov/preferences. ***ALL THE PREFERENCES MUST BE CLAIMED AND ARE APPLIED BY LINE ITEM, REGARDLESS OF WHETHER AWARD IS MADE BY ITEM OR LOT. VENDORS ARE CAUTIONED TO CAREFULLY REVIEW THE STATUTE BEFORE CLAIMING ANY PREFERENCES. THE REQUIREMENTS TO QUALIFY HAVE CHANGED. IF YOU REQUEST A PREFERENCE, YOU ARE CERTIFYING THAT YOUR OFFER QUALIFIES FOR THE PREFERENCE YOU'VE CLAIMED. IMPROPERLY REQUESTING A PREFERENCE CAN HAVE SERIOUS CONSEQUENCES.*** [11-35-1524(E)(4)&(6)]

PREFERENCES - ADDRESS AND PHONE OF IN-STATE OFFICE: Please provide the address and phone number for your in-state office in the space provided below. An in-state office is necessary to claim either the Resident Vendor Preference (11-35-1524(C)(1)(i)&(ii)) or the Resident Contractor Preference (11-35-1524(C)(1)(iii)). Accordingly, you must provide this information to qualify for the preference. An in-state office is not required, but can be beneficial, if you are claiming the Resident Subcontractor Preference (11-35-1524(D)).

_____ In-State Office Address same as Home Office Address
 _____ In-State Office Address same as Notice Address (check only one)

AMENDMENTS TO SOLICITATION (JAN 2004): (a) The Solicitation may be amended at any time prior to opening. All actual and prospective Offerors should monitor the following web site for the issuance of Amendments: <http://academicdepartments.musc.edu/vpfa/finance/purchasingap/index.htm> Vendors Toolkit Solicitation (b) Offerors shall acknowledge receipt of any amendment to this solicitation (1) by signing and returning the amendment, (2) by identifying the amendment number and date in the space provided for this purpose on Page Two, (3) by letter, or (4) by submitting a bid that indicates in some way that the bidder received the amendment. (c) If this solicitation is amended, then all terms and conditions which are not modified remain unchanged.[02-2A005-1]

Questions and Answers:

1. Will we allowed to utilize a fork lift in that area?

Not inside the building but on sidewalks or roadways that are wide enough to accommodate the forklift.

2. What is the duration time once purchase order is cut

All work must be completed by April 1, 2019

3. If the beam doesn't fist directly underneath the existing beam is there an alternate detail for he hanger?

See attached updated drawing revised 01/17/2019

- **S201 sheet 3 and S202 sheet 4 revised 01/17/2019 alternatives on hangers**
- **S201 sheet 3 revised 01/17/2019 for splice instructions**

4. If testing or inspection of the welds to be conducted we will not be responsible for the this cost correct.

- **All welding must be done according to American Welding Society standards of quality, AWS D1.1. as per Drawing Field Welding Note #1, Sheet 1.**
- **If required by owner, Third party inspections will be paid for by the owner (as per Drawing Field Welding Note #1, Sheet 10)**

5. Are the shop drawings required to be stamped?

They do not need to be signed and sealed and they need to be submitted for review and approval prior to fabrication.

6. Will MUSC be allocating parking spaces for at least two spaces for vehicles for the duration of this project?

Parking can be arranged for 2 vehicles

STRUCTURAL ABBREVIATIONS

AB	A. BOLT	IN	INCH
ADJ	ADJACENT	INCL	INCLUDE, ING
AFF	ABOVE FINISHED FLOOR	INT	INTERIOR
AHU	AIR HANDLING UNIT	LB	POUND
ALUM	ALUMINUM	LG	LONG
ALT	ALTERNATE	LL	LIVE LOAD
APPD	APPROVED	LLBB	LONG LEG BACK TO BACK
APPROX	APPROXIMATE	LLH	LONG LEG HORIZONTAL
ARCH	ARCHITECT	LLV	LONG LEG VERTICAL
		LONG	LONGITUDINAL
		LSL	LONG SLOTTED HOLES
		LT	LIGHT
		LTWT	LIGHTWEIGHT
B/	BOTTOM OF	MAS	MASONRY
BLDG	BUILDING	MAX	MAXIMUM
BM	BEAM	MECH	MECHANICAL
BOT	BOTTOM	MEZZ	MEZZANINE
BRDG	BRIDGING	MFR	MANUFACTURER
BRG	BEARING	MID	MIDDLE
BLK	BLOCK	MIN	MINIMUM
BTWN	BETWEEN	MISC	MISCELLANEOUS
		MJ	MASONRY JOINT
CANT	CANTILEVER	MO	MASONRY OPENING
C/C	CENTER TO CENTER		
CHAM	CHAMFER	N	NORTH
CIRC	CIRCULAR	NIC	NOT IN CONTRACT
CJ	CONTROL JOINT	NO	NUMBER NOM NOMINAL
CL	CLEAR	NS	NEAR SIDE
CMU	CONCRETE MASONRY UNITS	NTS	NOT TO SCALE
COL	COLUMN		
CONC	CONCRETE	O/O	OUT TO OUT
CONN	CONNECTION	OC	ON CENTER
CONX	CONNECTION	OD	OUTSIDE DIAMETER
CONST	CONSTRUCTION	OF	OUTSIDE FACE
CONT	CONTINUOUS	OPNG	OPENING
CONTR	CONTRACTOR	OPP	OPPOSITE
COORD	COORDINATE	OW	OPEN WEB
CTRD	CENTERED	PAF	POWDER ACTUATED FASTENER
		PL	PLATE
D	DEPTH	PLF	POUNDS PER LINEAL FOOT
DBL	DOUBLE	PROJ	PROJECTION
DET	DETAIL	PSF	POUNDS PER SQUARE FOOT
DIA	DIAMETER	PSI	POUNDS PER SQUARE INCH
DIAG	DIAGONAL	PT	PRESSURE TREATED
DIM	DIMENSION		
DL	DEAD LOAD	RAD	RADIUS
DWGS	DRAWINGS	REF	REFERENCE
		REINF	REINFORCEMENT
		RET	RETURN
E	EAST	REV	REVISION
EA	EACH	RP	RADIUS POINT
EB	EXPANSION BOLT	RT	RIGHT
EF	EACH FACE	RTU	ROOF TOP UNIT
EJ	EXPANSION JOINT		
EL	ELEVATION	S	SOUTH
ELEV	ELEVATOR	SA	SLEEVE ANCHOR
EMBED	EMBEDMENT	SB	SLAB BOLSTER
ENGR	ENGINEER	SCHED	SCHEDULE
EOS	EDGE OF SLAB	SECT	SECTION
EQ	EQUAL	SF	STEP FOOTING
EQU	EQUIPMENT	SIM	SIMILAR
EQUIV	EQUIVALENT	SPEC	SPECIFICATIONS
ES	EACH SIDE	SP	SPACINGS
EW	EACH WAY	SQ	SQUARE
EXP	EXPANSION	SSL	SHORT SLOTTED HOLES
EXIST	EXISTING	SS	STAINLESS STEEL
EXT	EXTERIOR	STD	STANDARD
		STIFF	STIFFENERS
		STL	STEEL
		STR	STRUCTURAL
		SYMM	SYMMETRICAL
FC	FILLED CELL		
FF	FINISHED FLOOR	T/	TOP OF
FIN	FINISH	TB	TIE BEAM
FLR	FLOOR	TC	TIE COLUMN
FDN	FOUNDATION	TCX	TOP CHORD EXTENSION
FRG	FRAMING	T&B	TOP AND BOTTOM
FT	FEET	TEMP	TEMPORARY
FTG	FOOTING	TRAN	TRANSVERSE
FV	FIELD VERIFY	TS	TUBE STEEL
		TP	TYPICAL
		TD	PRESSURE TREATED
GALV	GALVANIZED	UNO	UNLESS NOTED OTHERWISE
GA	GAUGE	VERT	VERTICAL
		W	WEST
HORIZ	HORIZONTAL	WTH	WIDTH
HSA	HEADED STUD ANCHOR	W/	WITH
HSB	HIGH STRENGTH BOLT	W/O	WITHOUT
HT	HEIGHT	WP	WORK POINT
		WS	WATERSTOP
ID	INSIDE DIAMETER	WT	WEIGHT
IF	INSIDE FACE	WWF	WELDED WIRE FABRIC

STRUCTURAL DESIGN CRITERIA

- GRAVITY LOAD DESIGN VALUES: IBC-2015/ ASCE 7-10
 LIVE LOADS:
 OFFICES 50-PSF
 CORRIDOR 80-PSF
 FOLDING PARTITION DOOR 125-LB/LF MAX WEIGHT
 SEE PLAN FOR ADDITIONAL FLOOR AND ROOF LIVE LOAD LOADING REQUIREMENTS.
 DEAD LOADS:
 ACTUAL MATERIAL WEIGHTS
 SOIL BEARING PRESSURE, (ALLOWABLE): PILE FOUNDATION (EXISTING, ASSUMED)
- SEISMIC DESIGN VALUES: IBC-2015/ ASCE 7-10
 $S_s = 1.126g$, $S_{ds} = 0.788g$
 $S_1 = 0.358g$, $S_{d1} = 0.402g$
 SITE CLASS: "D"
 BUILDING CATEGORY: "III"
 SEISMIC DESIGN CATEGORY: "D"
 SEISMIC FORCE RESISTING SYSTEM (EXISTING CHP BUILDING): ASCE 7-10
 SEISMIC FORCE RESISTING SYSTEM (EXISTING CHP BUILDING): ASCE 7-10
 SPECIALLY REINFORCED CONCRETE SHEAR WALLS (EXISTING, ASSUMED)
 $R = 6$ (EXISTING SYSTEM, ASSUMED)
 $C_d = 5$ (EXISTING SYSTEM, ASSUMED)
 $I = 1.25$ (EXISTING SYSTEM, ASSUMED)
 $T_L = 8.0$ (EXISTING SYSTEM, ASSUMED)
 $C_s = .164$ (EXISTING SYSTEM, ASSUMED)
 SEISMIC FORCE ON NONSTRUCTURAL COMPONENT (FOLDING PARTITION DOOR): ASCE 7-10 (CHAPTER 13&15)
 FOLDING PARTITION DOOR
 $R_p = 2.5$
 $q_p = 1.0$
 $I_p = 1.5$
 $F_p = 2.24$ KIPS
- WIND LOAD DESIGN VALUES: IBC-2015 (MWFRS)/ ASCE 7-10 (MWFRS)
 $V_{(ult)} = 158$ mph (3-sec gust) (MWFRS)
 EXPOSURE CATEGORY: "B"
 BUILDING CATEGORY: "III"
 $I = 1.00$
 $G_C p_i = +/- .18$
 $q_{(ult)} = 44.0$ - PSF $q_{i(ult)} = 7.9$ - PSF

GENERAL NOTES:

- STRUCTURAL DRAWINGS SHALL BE USED IN CONJUNCTION WITH ARCHITECTURAL AND MECHANICAL DRAWINGS AND DRAWINGS RELATING TO OTHER TRADES. CONTRACTOR SHALL BE RESPONSIBLE FOR CHECKING AND COORDINATING DIMENSIONS, CLEARANCES, ETC. WITH THE WORK OF OTHER TRADES. IN CASE OF CONFLICT BETWEEN DRAWINGS, THE MORE STRINGENT REQUIREMENT SHALL GOVERN.
- IN CASE OF CONFLICT BETWEEN THE DRAWINGS, NOTES AND SPECIFICATIONS, THE SPECIFICATIONS SHALL GOVERN.
- WORK NOT INDICATED ON A PART OF THE DRAWINGS BUT REASONABLY IMPLIED TO BE SIMILAR TO THAT SHOWN AT CORRESPONDING PLACES SHALL BE REPEATED.
- REVIEW ALL PROJECT DOCUMENTS PRIOR TO FABRICATION AND START OF CONSTRUCTION. REPORT ANY DISCREPANCIES TO A/E PRIOR TO PROCEEDING WITH WORK.
- IT IS THE PRIME CONTRACTOR'S RESPONSIBILITY TO PROTECT EXISTING FACILITIES, STRUCTURES AND UTILITY LINES FROM ALL DAMAGE DURING CONSTRUCTION.
- COORDINATE STRUCTURAL AND OTHER DRAWINGS THAT ARE PART OF THE CONTRACT DOCUMENTS FOR ANCHORED, EMBEDDED OR SUPPORTED ITEMS WHICH MAY AFFECT THE STRUCTURAL DRAWINGS.
- ALL DETAILS AND SECTIONS ON THE DRAWINGS ARE INTENDED TO BE TYPICAL AND SHALL BE CONSTRUED TO APPLY TO ANY SIMILAR SITUATION ELSEWHERE ON THE PROJECT EXCEPT WHERE A SEPARATE DETAIL IS SHOWN.
- USE OF CONTRACT DRAWINGS REPRODUCED IN WHILE OR ANY PART IN SHOP DRAWING SHALL NOT RELIEVE THE CONTRACTOR OR SUBCONTRACTORS FROM THEIR RESPONSIBILITY TO ACCURATELY LAYOUT, COORDINATE, DETAIL, FABRICATE AND INSTALL A COMPLETE STRUCTURE.
- REVIEW ALL SHOP DRAWINGS FOR CONFORMANCE WITH THE CONTRACT DOCUMENTS AND FOR COMPLETENESS AND ANSWER ALL CONTRACTOR RELATED QUESTIONS. STAMP AND INITIAL ALL SHEETS PRIOR TO SUBMITTING SHOP DRAWINGS TO OR A/E FOR REVIEW.

STRUCTURAL STEEL:

- ALL STRUCTURAL STEEL WORK SHALL CONFORM TO THE SPECIFICATIONS FOR THE DESIGN, FABRICATION, AND ERECTION OF STRUCTURAL STEEL FOR BUILDINGS, CURRENT EDITION, OF THE A.I.S.C.
- WELDS, BOTH SHOP AND FIELD, SHALL CONFORM TO THE A.W.S SPECIFICATIONS. ALL WELDS SHALL BE DONE WITH E-70 ELECTRODES
- STRUCTURAL STEEL SHOP DRAWINGS ARE REQUIRED AND SHALL BE SUBMITTED TO THE A/E FOR APPROVAL PRIOR TO FABRICATION. SHOP DRAWINGS SHALL NOT BE A REPRODUCTION OF THE CONTRACT DOCUMENTS. THE GENERAL CONTRACTOR SHALL REVIEW AND STAMP ALL SHOP DRAWINGS AND SUBMITTALS "APPROVED" PRIOR TO SUBMITTING TO ARCHITECT FOR REVIEW.
- (NOTE NOT USED.)
- STRUCTURAL STEEL MATERIALS SHALL CONFORM TO THE FOLLOWING ASTM SPECIFICATION (U.N.O.):
 WIDE FLANGES, STRUCTURAL TIES ASTM A992, F_y=50 KSI
 ANGLES, PLATES, MISC. STEEL ASTM A36, F_y=36 KSI
 THRD'D RODS ASTM A36, F_y=36 KSI
 TUBES/HSS ASTM A500, GRADE B
 PIPES ASTM A53, TYPE E OR S.
 ANCHOR BOLTS ASTM A449
 HIGH STRENGTH BOLTS ASTM A325 TYPE 1
- PROVIDE STIFFENER PLATES ON EACH SIDE OF WEB, BEAM OR GIRDER AT POINTS OF CONCENTRATED LOADS. MINIMUM STIFFENER PLATE THICKNESS SHALL BE 1/2" OR FLANGE THICKNESS OF SUPPORTING MEMBER, WHICHEVER IS GREATER, U.N.O.
- PROVIDE TEMPORARY BRACING OR GUYS TO PROVIDE LATERAL SUPPORT UNTIL PERMANENT LATERAL BRACING IS INSTALLED.
- THE PRIME CONTRACTOR SHALL PROVIDE WEB REINFORCEMENT AT OPENINGS IN STEEL BEAMS AND GIRDERS FOR MECHANICAL AND ELECTRICAL PENETRATIONS IF INDICATED ON MECHANICAL, STRUCTURAL OR ELECTRICAL DRAWINGS. ALL OPENINGS SHALL BE LOCATED AT THE CENTER OF THE BEAM WEB DEPTH.
- THE PRIME CONTRACTOR SHALL COORDINATE THE BOTTOM OF BASE PLATE ELEVATION WITH THE TOP OF CONCRETE ELEVATION. IN CASE OF CONFLICT, THE CONTRACTOR SHALL MAKE ALLOWANCE IN HIS BID FOR THE MORE STRINGENT REQUIREMENT.
- CUTS, HOLES, COPING, ETC. REQUIRED FOR WORK OF OTHER TRADES SHALL BE SHOWN ON THE SHOP DRAWINGS AND MADE IN THE SHOP. CUTS OR BURNING HOLES IN STRUCTURAL STEEL MEMBERS IN THE FIELD WILL NOT BE PERMITTED.
- ALL STEEL DETAILS AND CONNECTIONS SHALL BE IN ACCORDANCE WITH THE REQUIREMENT OF THE AISC SPECIFICATIONS (LATEST EDITION), INCLUDING ALL SUPPLEMENTS AND REVISIONS.
- SHOP CONNECTIONS NOT SPECIFICALLY DETAILED ON THE DRAWINGS MAY BE WELDED OR BOLTED UPON APPROVAL OF THE A/E. FIELD CONNECTIONS NOT SPECIFICALLY DETAILED ON THE DRAWING SHALL BE BOLTED UPON APPROVAL OF THE A/E.
- BEAM CONNECTIONS SHALL BE 3/4" DIAMETER A325 TYPE CONNECTION BOLT UNLESS OTHERWISE NOTED. ALL BEAM AND GIRDER CONNECTIONS, UNLESS SHOWN OTHERWISE, SHALL BE AT LEAST CAPABLE OF DEVELOPING THE UNIFORMLY DISTRIBUTED LOADING CAPACITY OF MEMBER OF ITS SPAN AS PER AISC MANUAL OF STEEL CONSTRUCTION (LATEST EDITION).
- ALTERNATE CONNECTION DETAILS MAY BE USED IF SUCH DETAILS ARE SUBMITTED TO THE A/E FOR REVIEW AND ACCEPTANCE IS GRANTED. HOWEVER, THE A/E SHALL BE THE SOLE JUDGE OF ACCEPTABILITY AND THE PRIME CONTRACTOR'S BID SHALL ANTICIPATE THE USE OF THESE SPECIFIC DETAILS SHOWN ON THE DRAWINGS. IN ANY EVENT, THE CONTRACTOR SHALL BE RESPONSIBLE FOR THE DESIGN OF SUCH ALTERNATE DETAILS WHICH HE PROPOSES.
- FOR LOCATION OF LINTELS, SEE ARCHITECTURAL DRAWINGS. FOR SIZE OF LINTELS, SEE SCHEDULE. HUNG LINTELS SHALL BE PROVIDED AND INSTALLED BY STRUCTURAL STEEL CONTRACTOR. LOOSE LINTELS SHALL BE SUPPLIED AND INSTALLED BY MISCELLANEOUS IRON AND STEEL CONTRACTOR.
- STEEL FABRICATOR SHALL SUPPLY ANCHOR BOLT LOCATION DRAWINGS.
- BOTTOMS OF ALL COLUMNS SHALL BE MILLED.
- FILLET WELD SIZES NOT CALLED OUT HEREIN SHALL BE 3/16" MINIMUM.

FIELD WELDING:

- ALL FIELD WELDING SHALL BE IN ACCORDANCE WITH AWS D1.1 STRUCTURAL WELDING CODE (LATEST EDITION)
- WELDING SHALL BE PERFORMED BY QUALIFIED WELDERS. CONTRACTOR SHALL SUBMIT WELDING CERTIFICATES FOR APPROVAL.
- ALL WELDING ELECTRODES SHALL BE E70 WITH A MINIMUM YIELD STRENGTH OF 58KSI, MINIMUM TENSILE STRENGTH OF 70 KSI, AND MINIMUM ELONGATION OF 22% IN ACCORDANCE WITH AWS A5.
- FIELD WELDING SHALL BE SHOWN ON ERECTION DRAWINGS.
- REPAIR ALL DAMAGED PRIMER AT ADJACENT AREAS AFTER WELD INSPECTION IS COMPLETE.
- MINIMUM WELD FOR FRAMING AND MISCELLANEOUS STEEL SHALL BE 3/16" FILLET WELD ALL AROUND UNLESS NOTED OTHERWISE.
- ALL WELD FILLER METAL SHALL HAVE A MINIMUM CVN TOUGHNESS OF 20 FT-LBS AT MINUS 10 DEGREES FAHRENHEIT AND 40 FT-LB AT 70° FAHRENHEIT.
- THE PRIME CONTRACTOR SHALL SCHEDULE WELD TESTING AND INSPECTION SUCH THAT REPORTS MAY BE REVIEWED BY THE EOR AND APPROVAL OR RECOMMENDATION FOR FURTHER TESTING OR REMEDIAL ACTION MAY BE MADE WHILE WELDS ARE STILL ACCESSIBLE.
- SUBCONTRACTOR SHALL SUBMIT DETAIL WELD PROCEDURE FOR EACH TYPE OF WELD TO BE COMPLETED. INFORMATION SHALL BE MADE AVAILABLE TO THE WELD INSPECTOR.
- TESTING AND INSPECTION OF FIELD WELDS SHALL BE CONDUCTED BY AN INDEPENDENT TESTING AGENCY (COMMISSIONED BY THE OWNER) IN ACCORDANCE WITH THE SCHEDULE OF SPECIAL INSPECTIONS.

GENERAL NOTE:

THE G.C. SHALL FIELD VERIFY ALL EXISTING STEEL ELEVATIONS AND DIMENSIONS

THE G.C. SHALL COORD. NEW EQUIPMENT LAYOUT W/ EXISTING STEEL.

THE G.C. SHALL COORD. FOLDING PARTITION DOOR EQUIPMENT LAYOUT AND ATTACHMENT TO NEW STEEL PRIOR TO STEEL FABRICATION.

ALL ITEMS SHALL BE VERIFIED PRIOR TO NEW STEEL FABRICATION.

CONTRACTOR NOTE:

THE G.C. SHALL PROVIDE TOUCH UP COATINGS AS REQUIRED AT LOCATIONS OF SCRATCHES, WELDS AND ANY OTHER DAMAGED OR UNCOATED AREA DUE TO A CONNECTION, OR CONTACT WITH AN ALTERNATE MATERIAL, ETC..

THE G.C. SHALL REPLACE FIREPROOFING AS REQUIRED AT LOCATIONS OF FIREPROOFING REMOVAL FOR THE INSTALLATION OF NEW FRAMING.

NEW FIRE PROOFING SHALL MATCH EXISTING ADJACENT

MUSCH CHP
Charleston, South Carolina

MUSCH CHP 1ST FLOOR FOLDING PARTITION
DOOR (ROOM 105)

CHARLESTON
SOUTH CAROLINA




ENGINEERING SPECIALISTS
 SITE SERVICES \ BUILDING ENVELOPE \ STRUCTURAL
 1224 YEAMANS HALL ROAD
 HANAHAN, SC 29410
 843-566-0161
 fax 843-566-0162
 ADCENGINEERING.COM

DATE:	4-27-2018
ADC PROJECT #:	18026.0
DESIGNED:	CJG
CHECKED:	CJG
DRAWN:	VG
REVISION:	

GENERAL NOTES
AND
DESIGN CRITERIA

S000

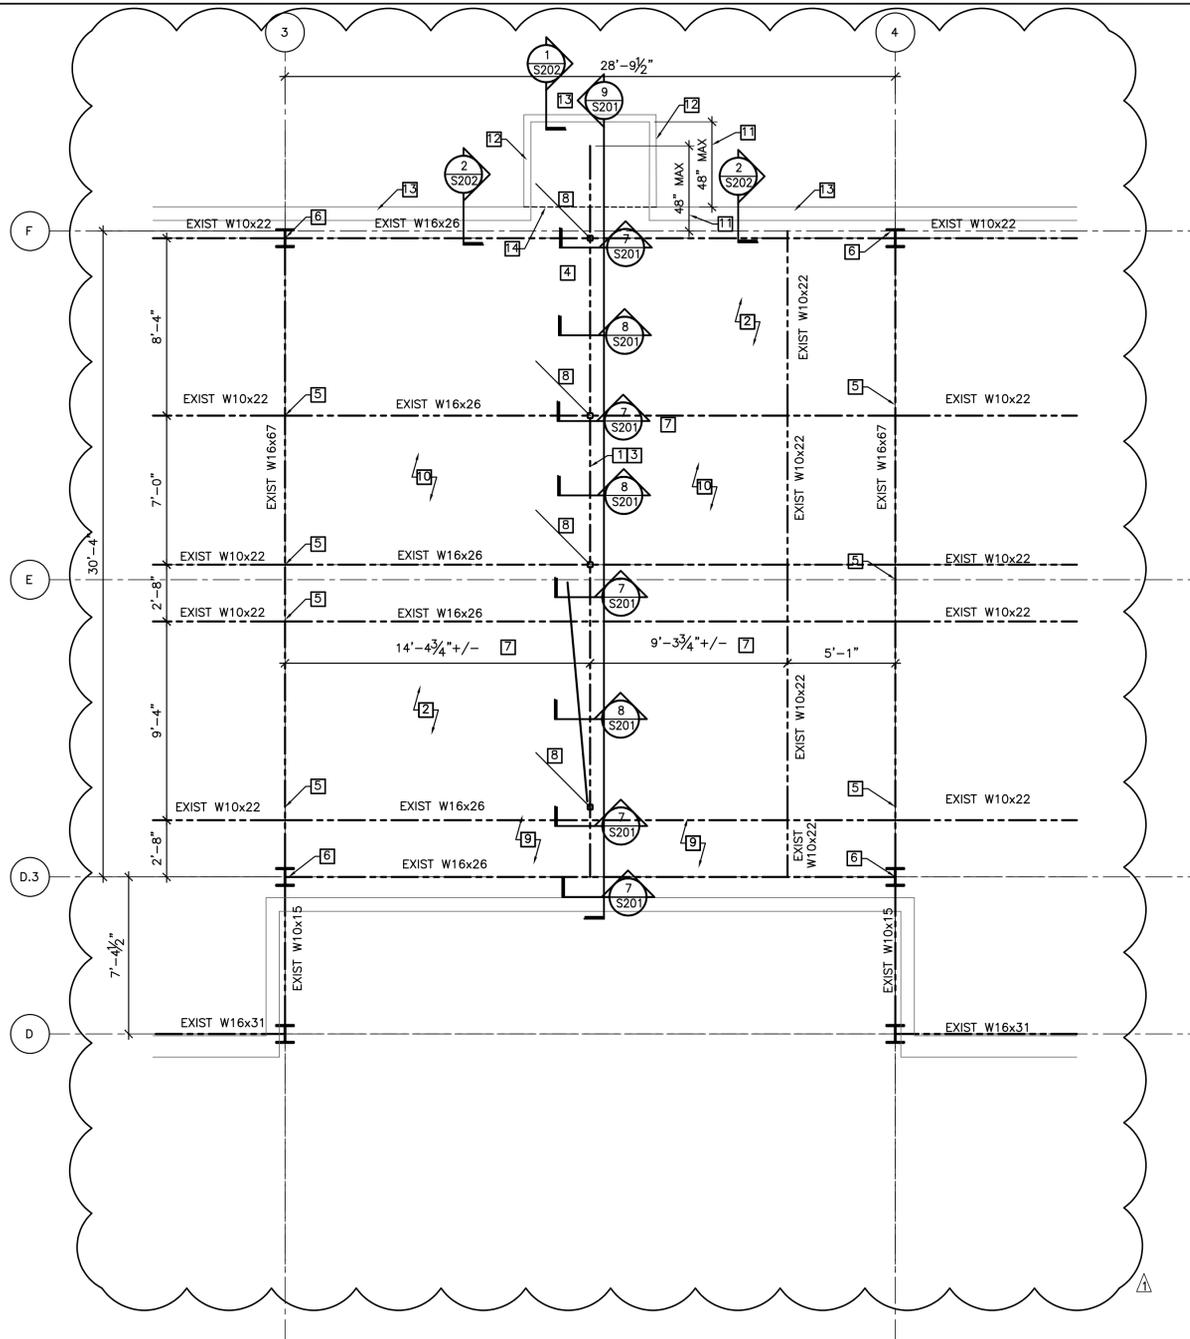

1 SECOND FLOOR FRAMING PLAN
S101

SCALE: 1/4" = 1'-0"

DRAWING NOTES: [7]

- APPLY TO THIS DRAWINGS ONLY
- 1 NEW W8x18, CONT.
 - 2 EXISTING SLAB ABOVE
 - 3 MAXIMUM DOOR WEIGHT = 125-LBS/FT
 - 4 DOOR TO STACK IN THIS LOCATION. IF OWNER WANTS ALTERNATE LOCATION, NOTIFY EOR SO ALTERNATE PLAN MAY BE PROVIDED.
 - 5 PROVIDE ADDITIONAL WELD @ CONNECTION OF EXISTING BEAM TO EXISTING BEAM PER TYPICAL DETAIL 1/S201.
 - 6 PROVIDE ADDITIONAL WELD @ CONNECTION OF EXISTING BEAM TO EXISTING COLUMN PER TYPICAL DETAIL 4/S201.
 - 7 G.C. TO COORDINATE WITH OWNER FOR EXACT DOOR LOCATION.
 - 8 HSS 3x3x1/4 HANGER.
 - 9 G.C. TO REMOVE AND REPLACE GYP. CEILING AS REQUIRED. REPLACE TO MATCH EXISTING ADJACENT.
 - 10 G.C. TO REMOVE AND REPLACE DROP CEILING. REPLACE TO MATCH EXISTING ADJACENT.
 - 11 G.C. TO COORDINATE W/ DOOR SUPPLIER.
 - 12 362S162x20GA METAL STUDS @ 16"o.c.
 - 13 INFILL METAL STUD FRAMING W/ 362S162x20GA STUDS @ 16"o.c.
 - 14 G.C. SHALL MOVE CONDUIT & WIRING SO AS NOT TO INTERFERE W/ NEW BEAM & DOOR. G.C. TO FIELD LOCATE NEW CONDUIT & EXTENT.

ELEVATIONS:

T/1ST FLOOR SLAB	=	0'-0"
T/DOOR	=	9'-8 1/2" ±
B/NEW BEAM (W8x18)	=	10'-3" ±
B/EXISTING CONDUIT	=	10'-1 1/4" ± G.C. TO F.V.
T/EXISTING W16x26	=	15'-1 1/4" ± G.C. TO F.V.

MUSCH, C.H.P.
Charleston, South Carolina

**MUSC CHP 1ST FLOOR FOLDING PARTITION
DOOR (ROOM 105)**

CHARLESTON
SOUTH CAROLINA



ADC
ENGINEERING SPECIALISTS
SITE SERVICES \ BUILDING ENVELOPE \ STRUCTURAL
1224 YEAMANS HALL ROAD
HANAHAN, SC 29410
843-566-0161
fax 843-566-0162
ADCEngineering.com


DATE:	4-27-2018
ADC PROJECT #:	18026.0
DESIGNED:	CJG
CHECKED:	CJG
DRAWN:	VG
REVISION:	

REVISD 09.10.2018

**SECOND FLOOR
FRAMING PLAN**


S101

NOTE:
G.C. TO VERIFY CONNECTION IS MINIMUM 3/8" TAB PLATE, W/
3-3/4" A325 STD. BOLTS. IF CONNECTION IS NOT AS
INDICATED, NOTIFY A/E FOR ALTERNATE CONNECTION. G.C. TO
PROVIDE ALLOWANCE IN BID OF \$2000.00 PER CONNECTION FOR
ALTERNATE CONNECTION

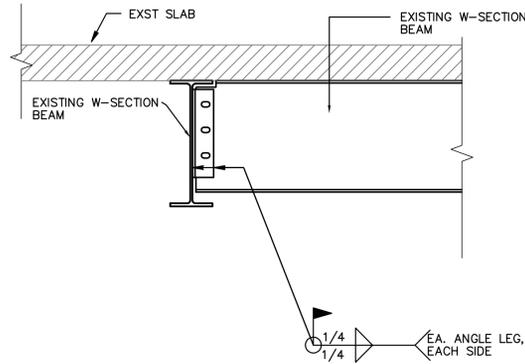

1 SECTION (TYPICAL)


SCALE: 1"=1'-0"

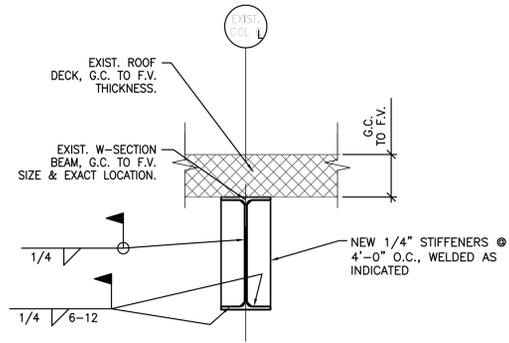

2 SECTION (TYPICAL)


SCALE: 1"=1'-0"

NOTE:
G.C. TO VERIFY CONNECTION IS MINIMUM 3/8"
TAB PLATE, W/ 4-3/4" A325 STD. BOLTS.
IF CONNECTION IS NOT AS INDICATED, NOTIFY
A/E FOR ALTERNATE CONNECTION. G.C. TO
PROVIDE ALLOWANCE IN BID OF \$2000.00 PER
CONNECTION FOR ALTERNATE CONNECTION

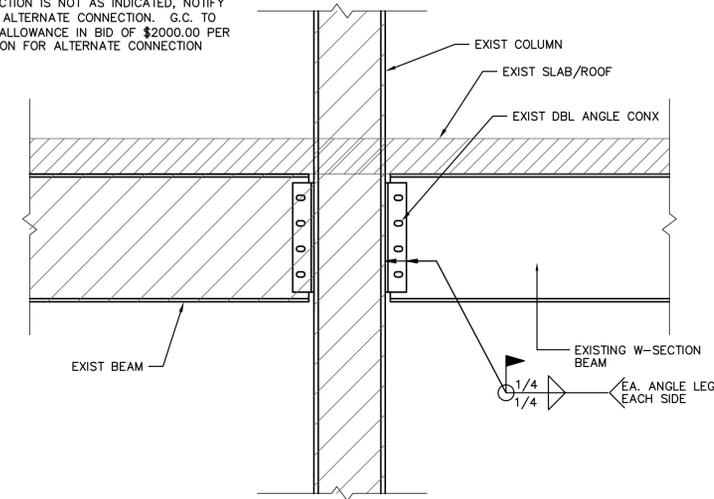


4 SECTION (TYPICAL)

SCALE: 1"=1'-0"

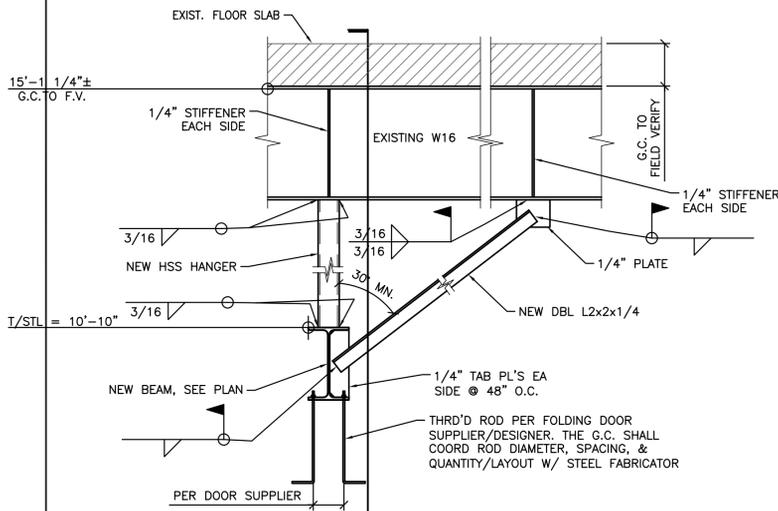


7 SECTION (TYPICAL)

SCALE: 1"=1'-0"

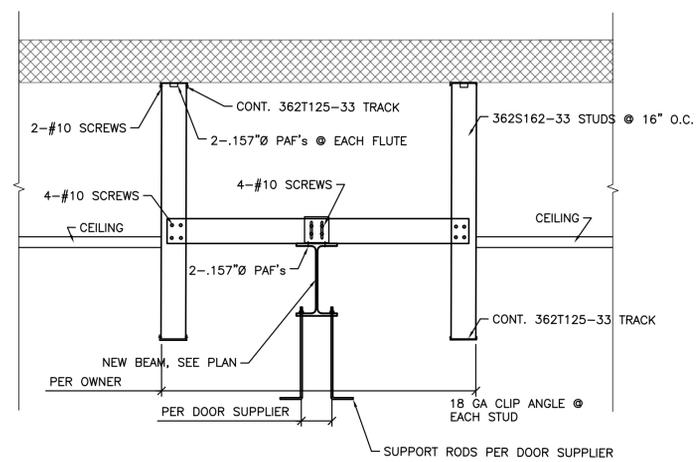

8 SECTION (TYPICAL)

SCALE: 1"=1'-0"

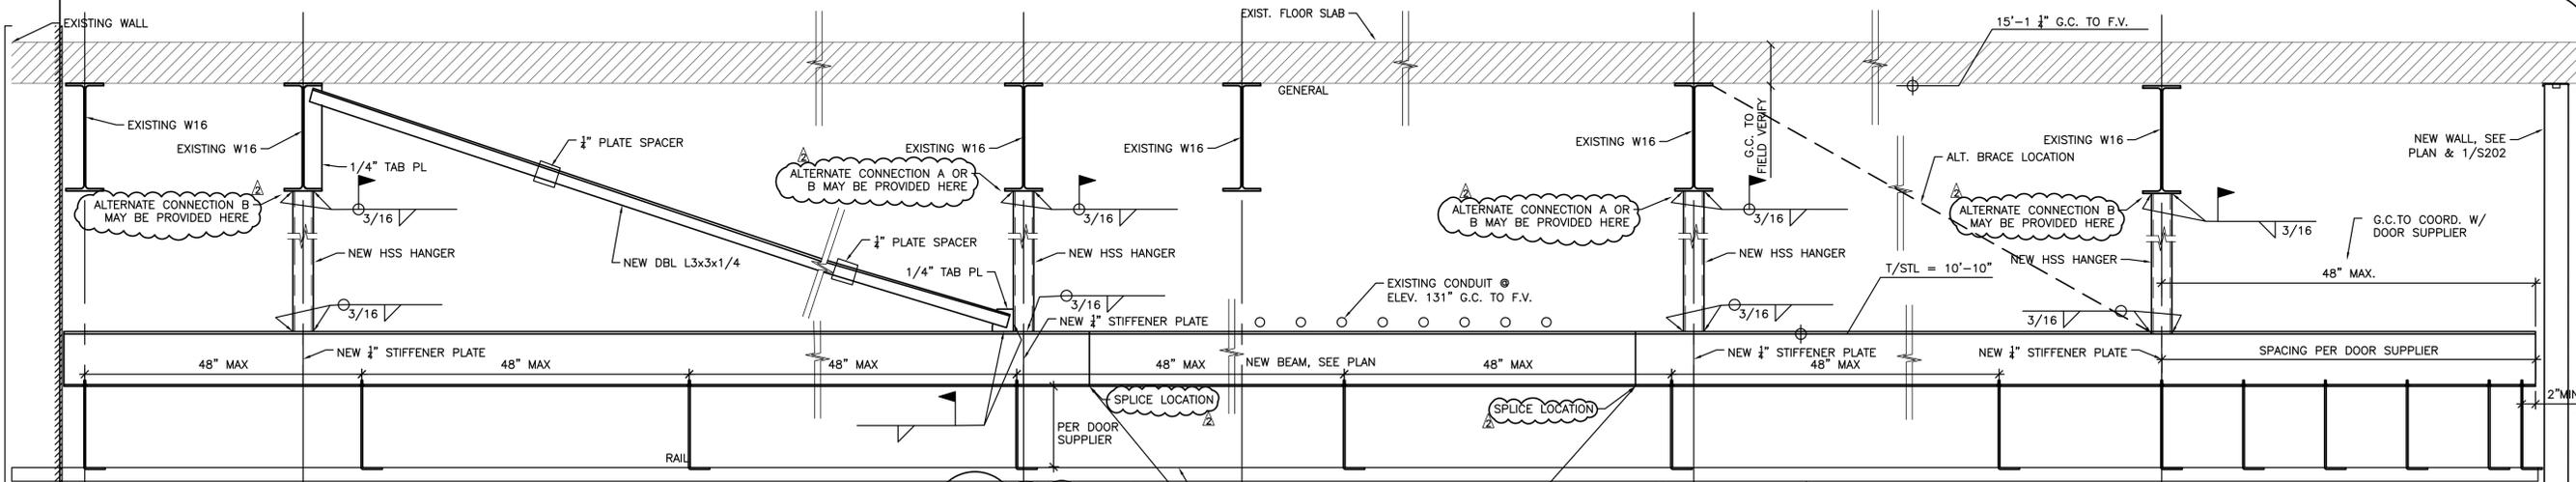

9 SECTION

SCALE: 1"=1'-0"

MUSCH CHP
Charleston, South Carolina

MUSCH CHP 1ST FLOOR FOLDING PARTITION
DOOR (ROOM 105)

CHARLESTON
SOUTH CAROLINA



ENGINEERING SPECIALISTS
SITE SERVICES \ BUILDING ENVELOPE \ STRUCTURAL
1226 YEAMANS HALL ROAD
HANAHAN, SC 29410
843-566-0161
Fax 843-566-0162
ADCENGINEERING.COM

DATE: 4-27-2018
ADC PROJECT #: 18026.0
DESIGNED: C/JG
CHECKED: C/JG
DRAWN: VG
REVISION:



REVISED 09.10.2018
REVISED 01.17.2019

TYPICAL SECTIONS
AND DETAILS

S201



CONSTRUCTION DOCUMENTS

SHEET 3 OF 4

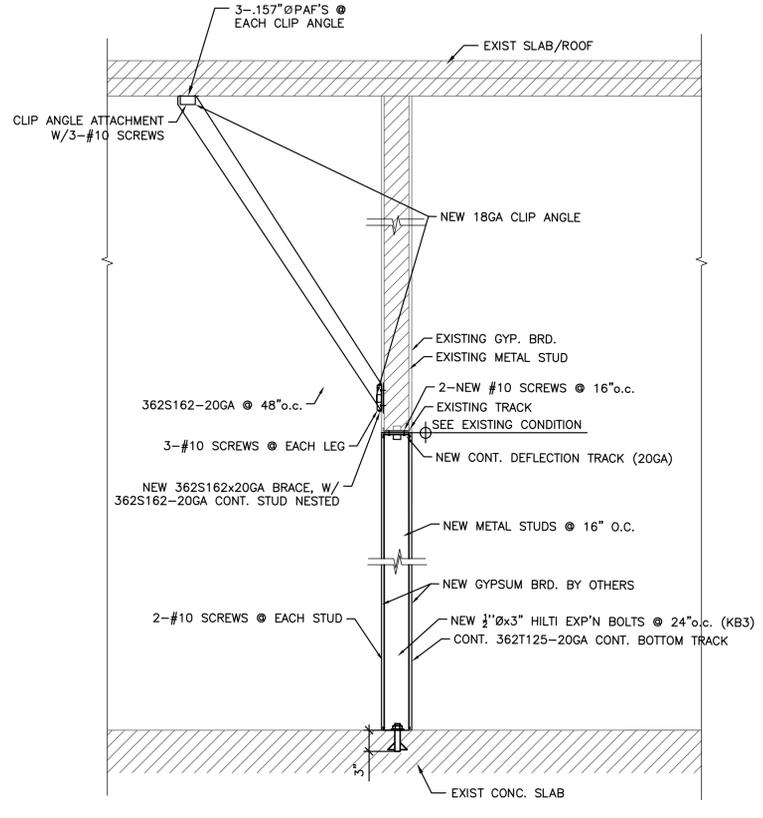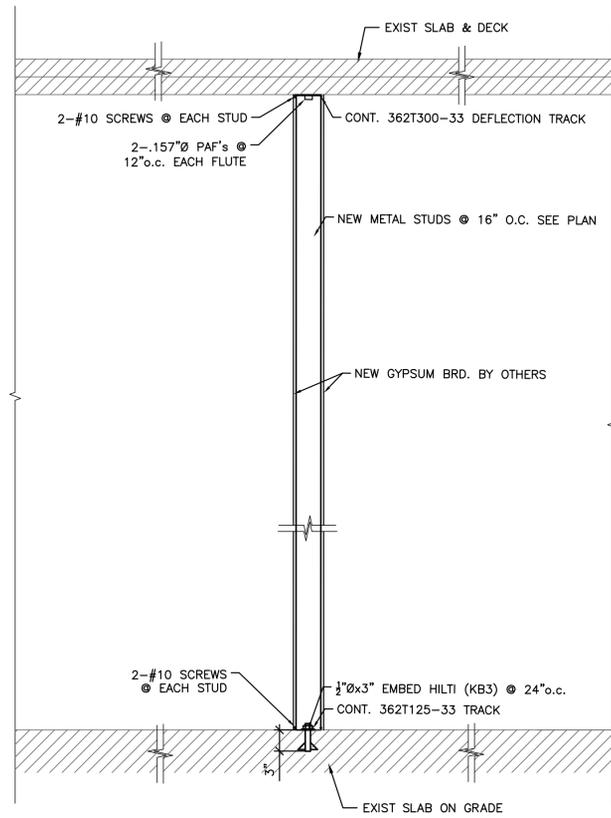

1 SECTION (TYPICAL)
SCALE: 1"=1'-0"

2 SECTION (TYPICAL)
SCALE: 1"=1'-0"

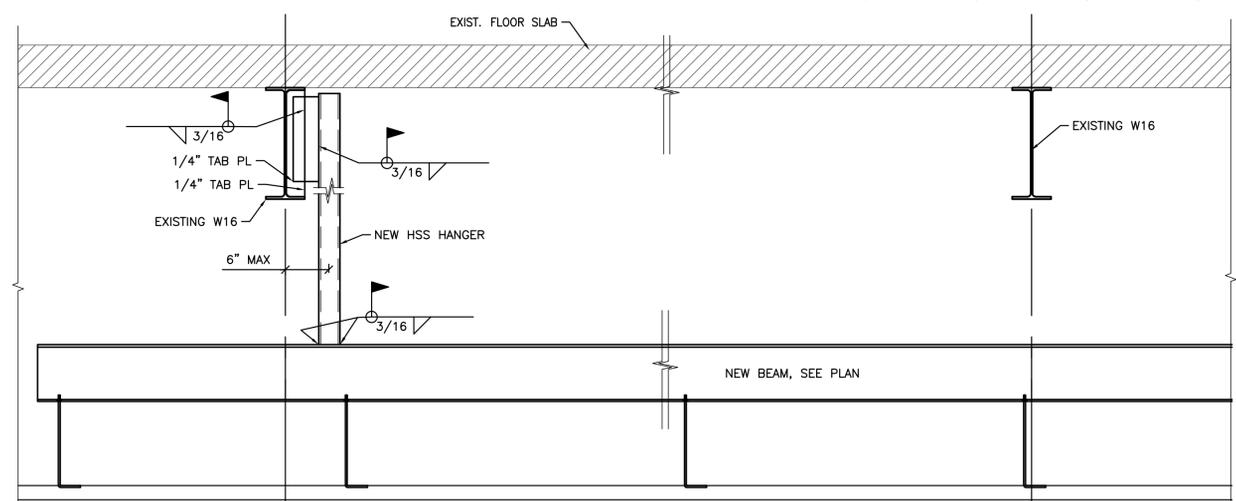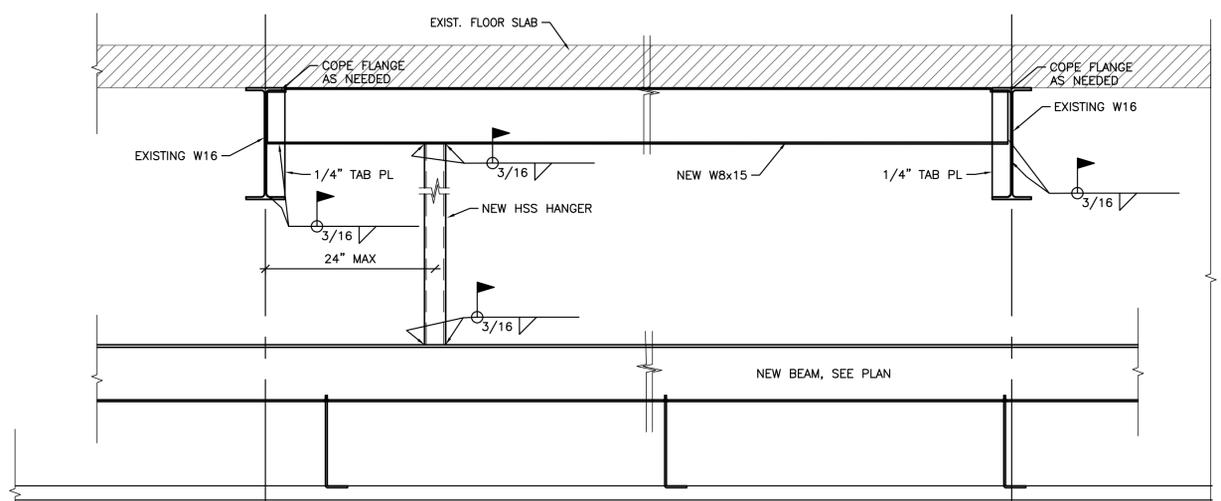

3 ALTERNATE A (NON-CANTILEVERED END)
ALTERNATE POST TO EXISTING STRUCTURE ATTACHMENT DETAIL
SCALE: 1"=1'-0"

ALTERNATE B (@ CANTILEVERED END)
SCALE: 1"=1'-0"

MUSCH, CHP
Charleston, South Carolina

MUSCH CHP 1ST FLOOR FOLDING PARTITION
DOOR (ROOM 105)

CHARLESTON
SOUTH CAROLINA



ENGINEERING SPECIALISTS
SITE SERVICES \ BUILDING ENVELOPE \ STRUCTURAL
1224 YEAMANS HALL ROAD
HANAHAN, SC 29410
843-566-0161
843-566-0162
ADCENGINEERING.COM

DATE:	4-27-2018
ADC PROJECT #:	18026.0
DESIGNED:	CJG
CHECKED:	CJG
DRAWN:	VG
REVISION:	

REVISION 01.17.2019

TYPICAL SECTIONS
AND DETAILS

S202